





Stewart
Management & Planning Solutions



PEGASUS ARCHITECTURE

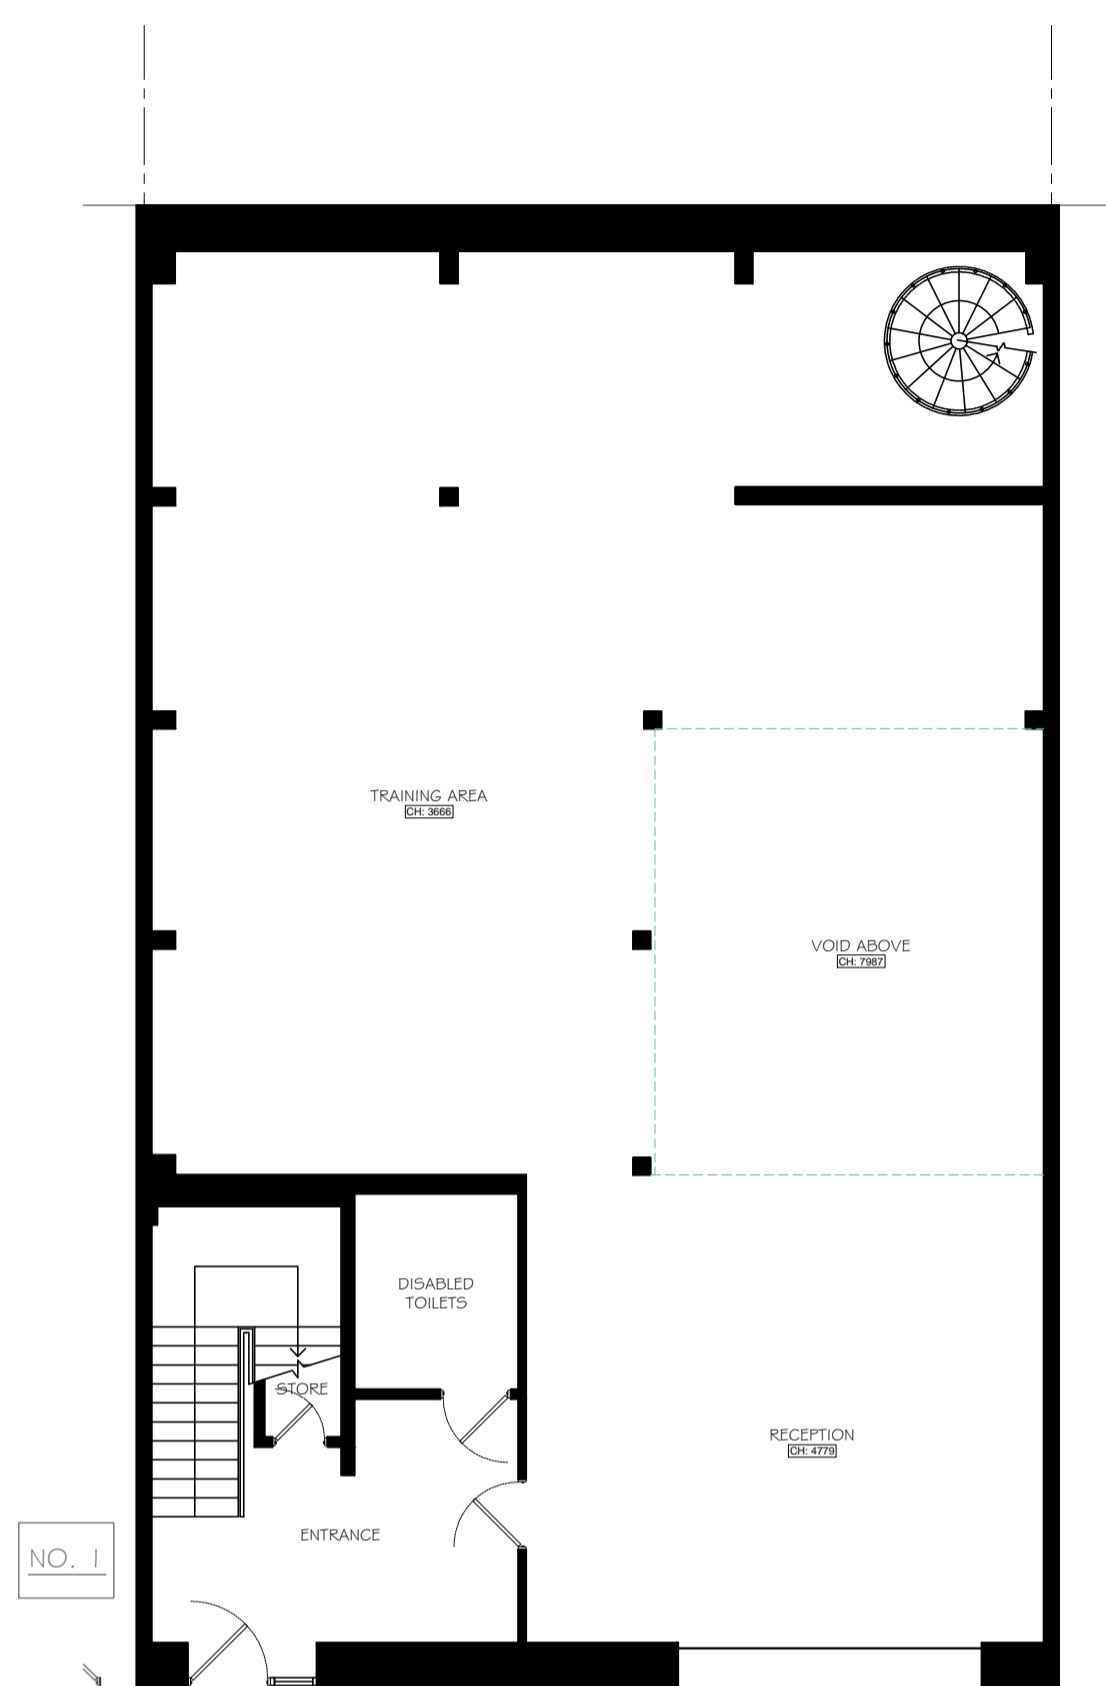

EXISTING GROUND FLOOR PLAN
1:100

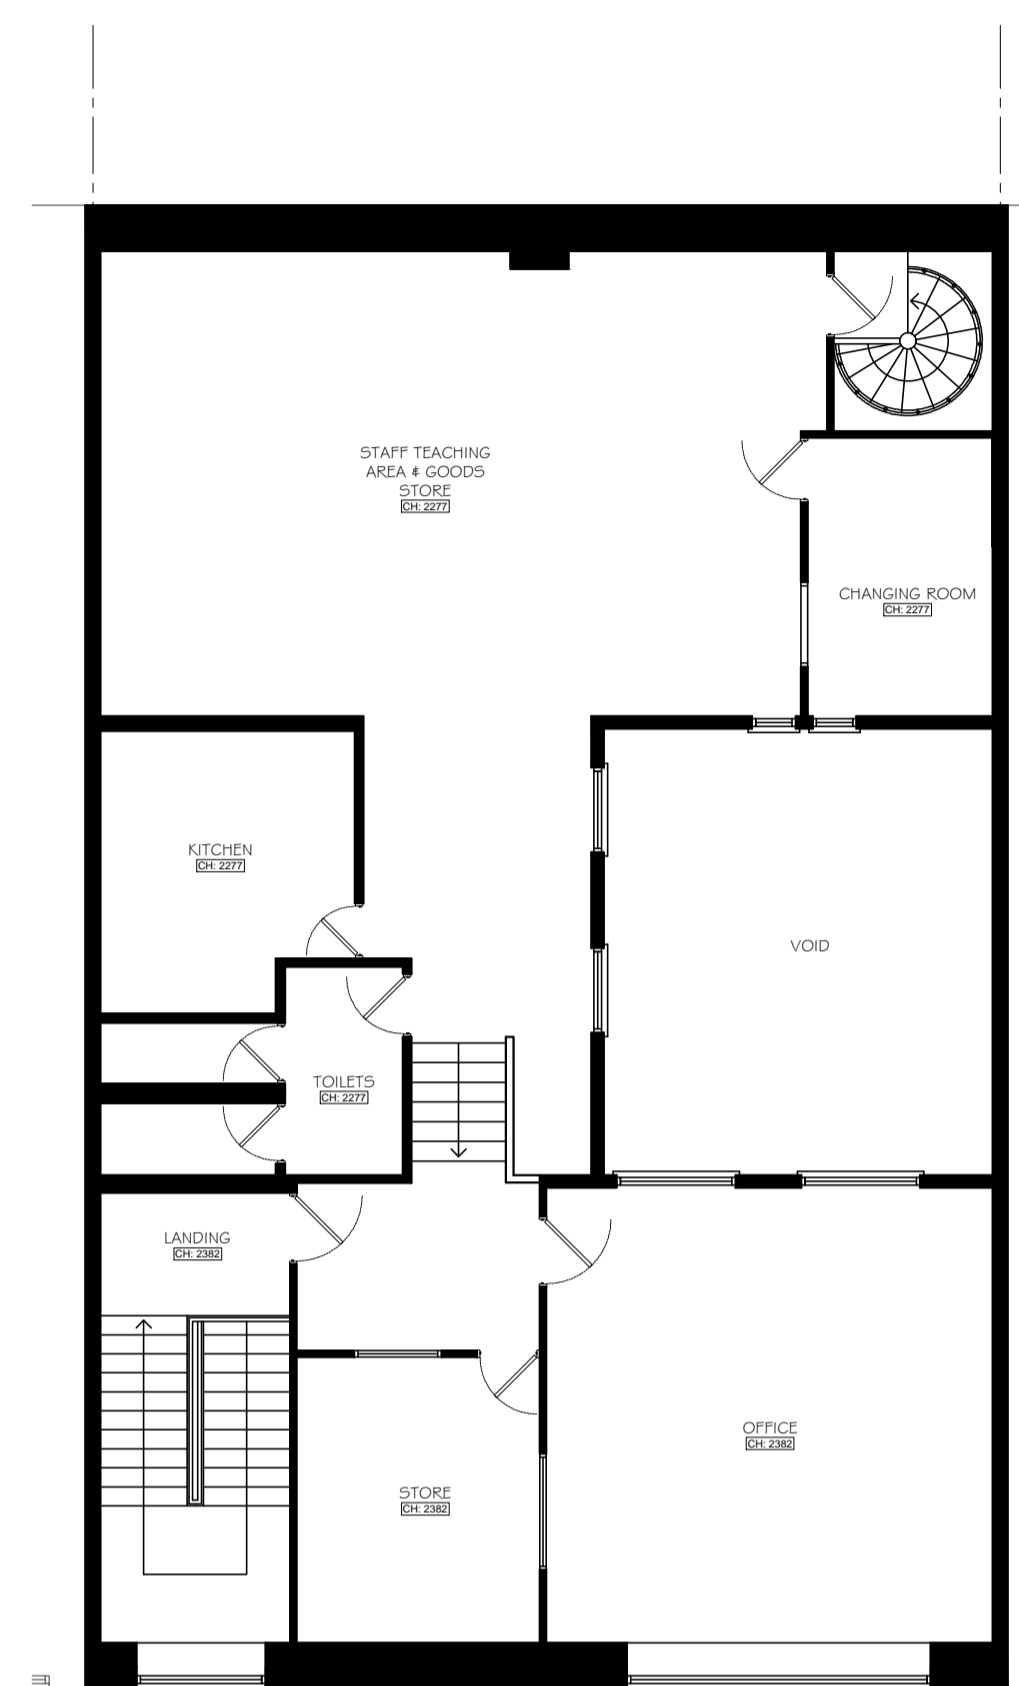

EXISTING FIRST FLOOR PLAN
1:100

PEGASUS ARCHITECTURE ACCEPT NO RESPONSIBILITY FOR COSTS, LOSSES, CLAIMS HOWEVER ARISING FROM THESE DRAWINGS SPECIFICATION AND RELATED DOCUMENTS UNLESS THERE IS FULL COMPLIANCE WITH THE CLIENT AND ANY AUTHORIZED USER (APPOINTED BUILDER) OF THE FOLLOWING:
1. ALL BOUNDARIES, DIMENSIONS AND LEVELS ARE FOR GUIDANCE ONLY AND MUST BE CHECKED ON SITE BEFORE CONSTRUCTION AND ANY DISCREPANCIES ARE TO BE REPORTED TO THE PLANNER / DESIGNER.
2. FOR CONSTRUCTION PURPOSES, USE GIVEN DIMENSIONS ONLY AND DO NOT SCALE.
3. FOR THE PURPOSE OF COORDINATION, ALL RELEVANT PARTIES MUST CHECK THIS INFORMATION PRIOR TO IMPLEMENTATION AND REPORT ANY DISCREPANCIES TO THE DESIGNER.
4. SURVEY INFORMATION HAS BEEN TAKEN USING LASER MEASUREMENT AND MAY BE OPEN TO MINOR TOLERANCES.
ALL SETTING OUT INFORMATION MUST BE CHECKED PRIOR TO CONSTRUCTION BY THE APPOINTED BUILDER TO ENSURE SITE ACCURACY.
DO NOT SCALE FROM THESE DRAWINGS UNLESS FOR PLANNING PURPOSES.

PROJECT
Unit 2
Sperrin Business Centre
Ruislip
HA4 0BG

DOCUMENT DATE
17 May 2018

DOCUMENT PHASE
PLANNING

SCALE
AS NOTED AT A1 PAGE SIZE

Rev Date Remark
A 14.05.18 As per Client Comment

'As Built'
Floor
Plans
A1.2

